

HIGH EXPOSURE RETAIL/OFFICE SPACE

Centennial Shops • Colorado Springs


- Garden of the Gods Market • 2935 sq. ft.
- Great Location – High Exposure
- Good Co-tenancy – Bamboo Court Restaurant and Canyon Crest Liquor
- Ideal for Financial Services, Real Estate, Physical Therapy, Spa
- High Traffic / Retail



See us on the web at

www.firstproperties1.co



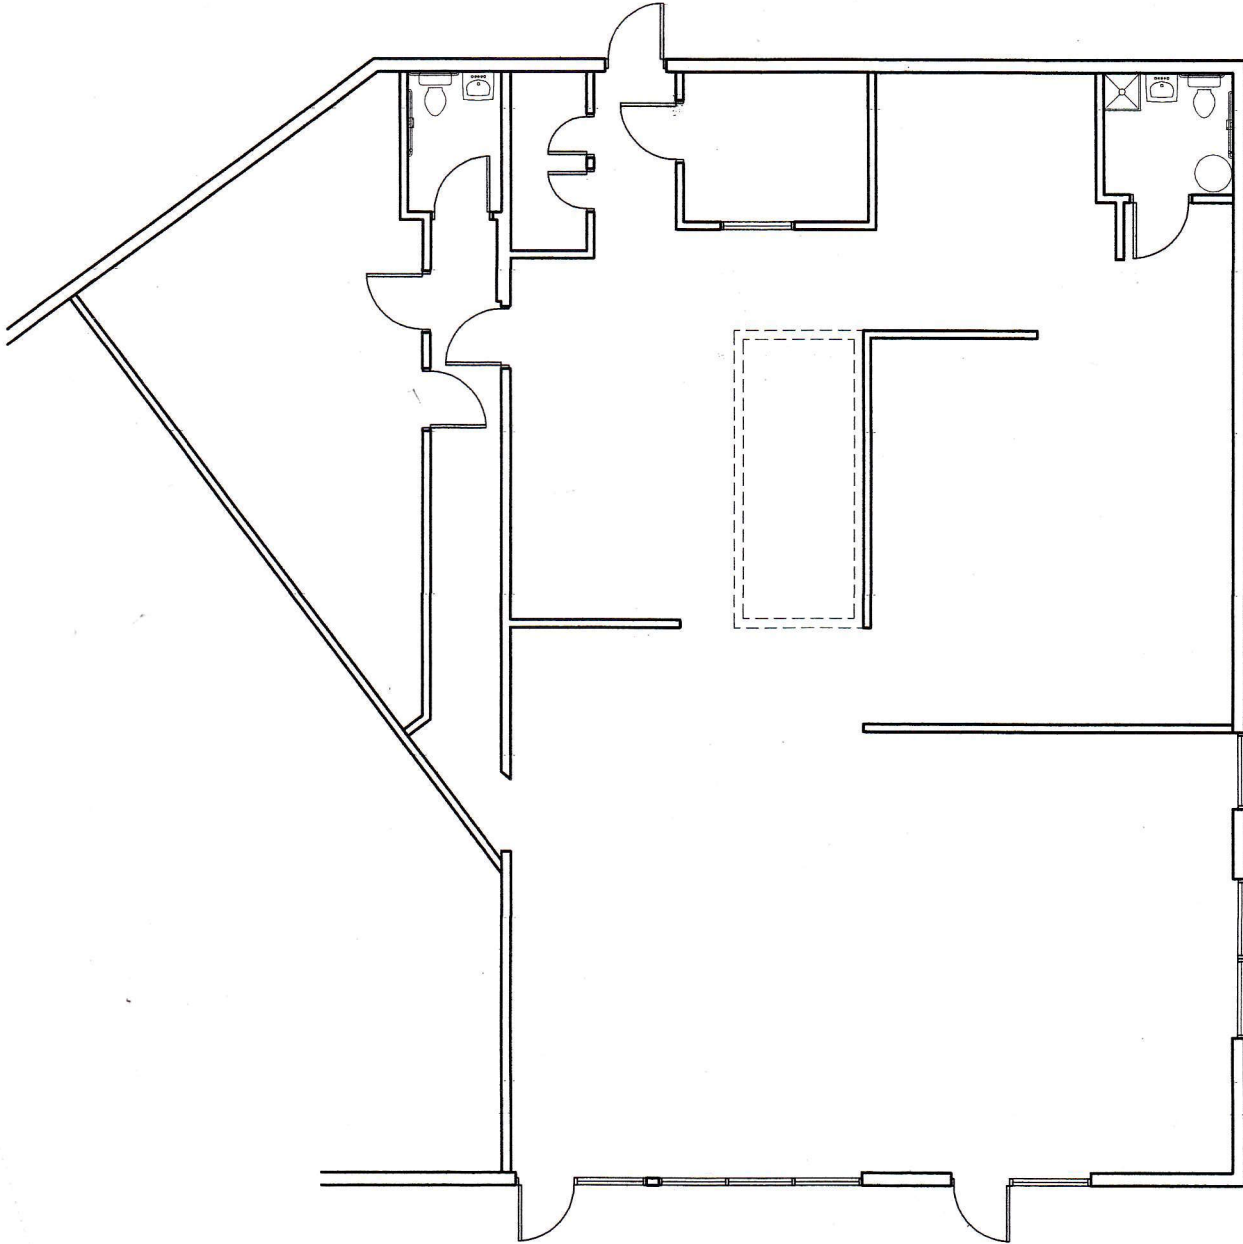

AS-BUILT FLOOR PLAN - 1956

2,969.30 S.F.